



ADDENDUM No. 1

2015 WALLA WALLA PEDESTRIAN IMPROVEMENTS PROJECT
PWE NO. ST14002
FEDERAL AID NO. TAP-9936(002)

Addendum No. 1 to the Plans, Specifications and Contract Documents is hereby submitted via email and/or facsimile for use in bid preparations and submittal.

The following changes, additions, and/or deletions are hereby made a part of the **2015 WALLA WALLA PEDESTRIAN IMPROVEMENTS PROJECT**, dated March 24, 2016 as fully and completely as if the same were entirely set forth in the Plans, Specifications, and Contract Documents. Changes and additions are noted in ***bold italics***, and deletions are noted in ~~strikethrough~~.

PLANS

Sheet P3, Rose Street pedestrian crossing and RRFB.


Modify notes for RRFB and Pedestrian push button pole to include WSDOT Standard Plan references for foundation size and reinforcing steel requirements.


Add note to extend landing at the top of the ramp on the south side of Rose Street.

Modify notes for stop line location distance.

Notice is hereby given that this addendum must be acknowledged on the proposal for the **2015 WALLA WALLA PEDESTRIAN IMPROVEMENTS PROJECT**, as evidence that the bidder is familiar with all changes incorporated herein.

Submitted by:
Doug Eaton, P.E.
Civil Engineer I

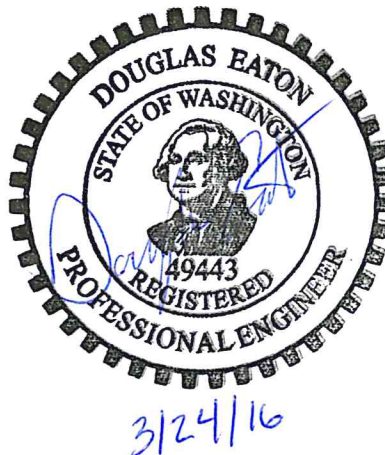

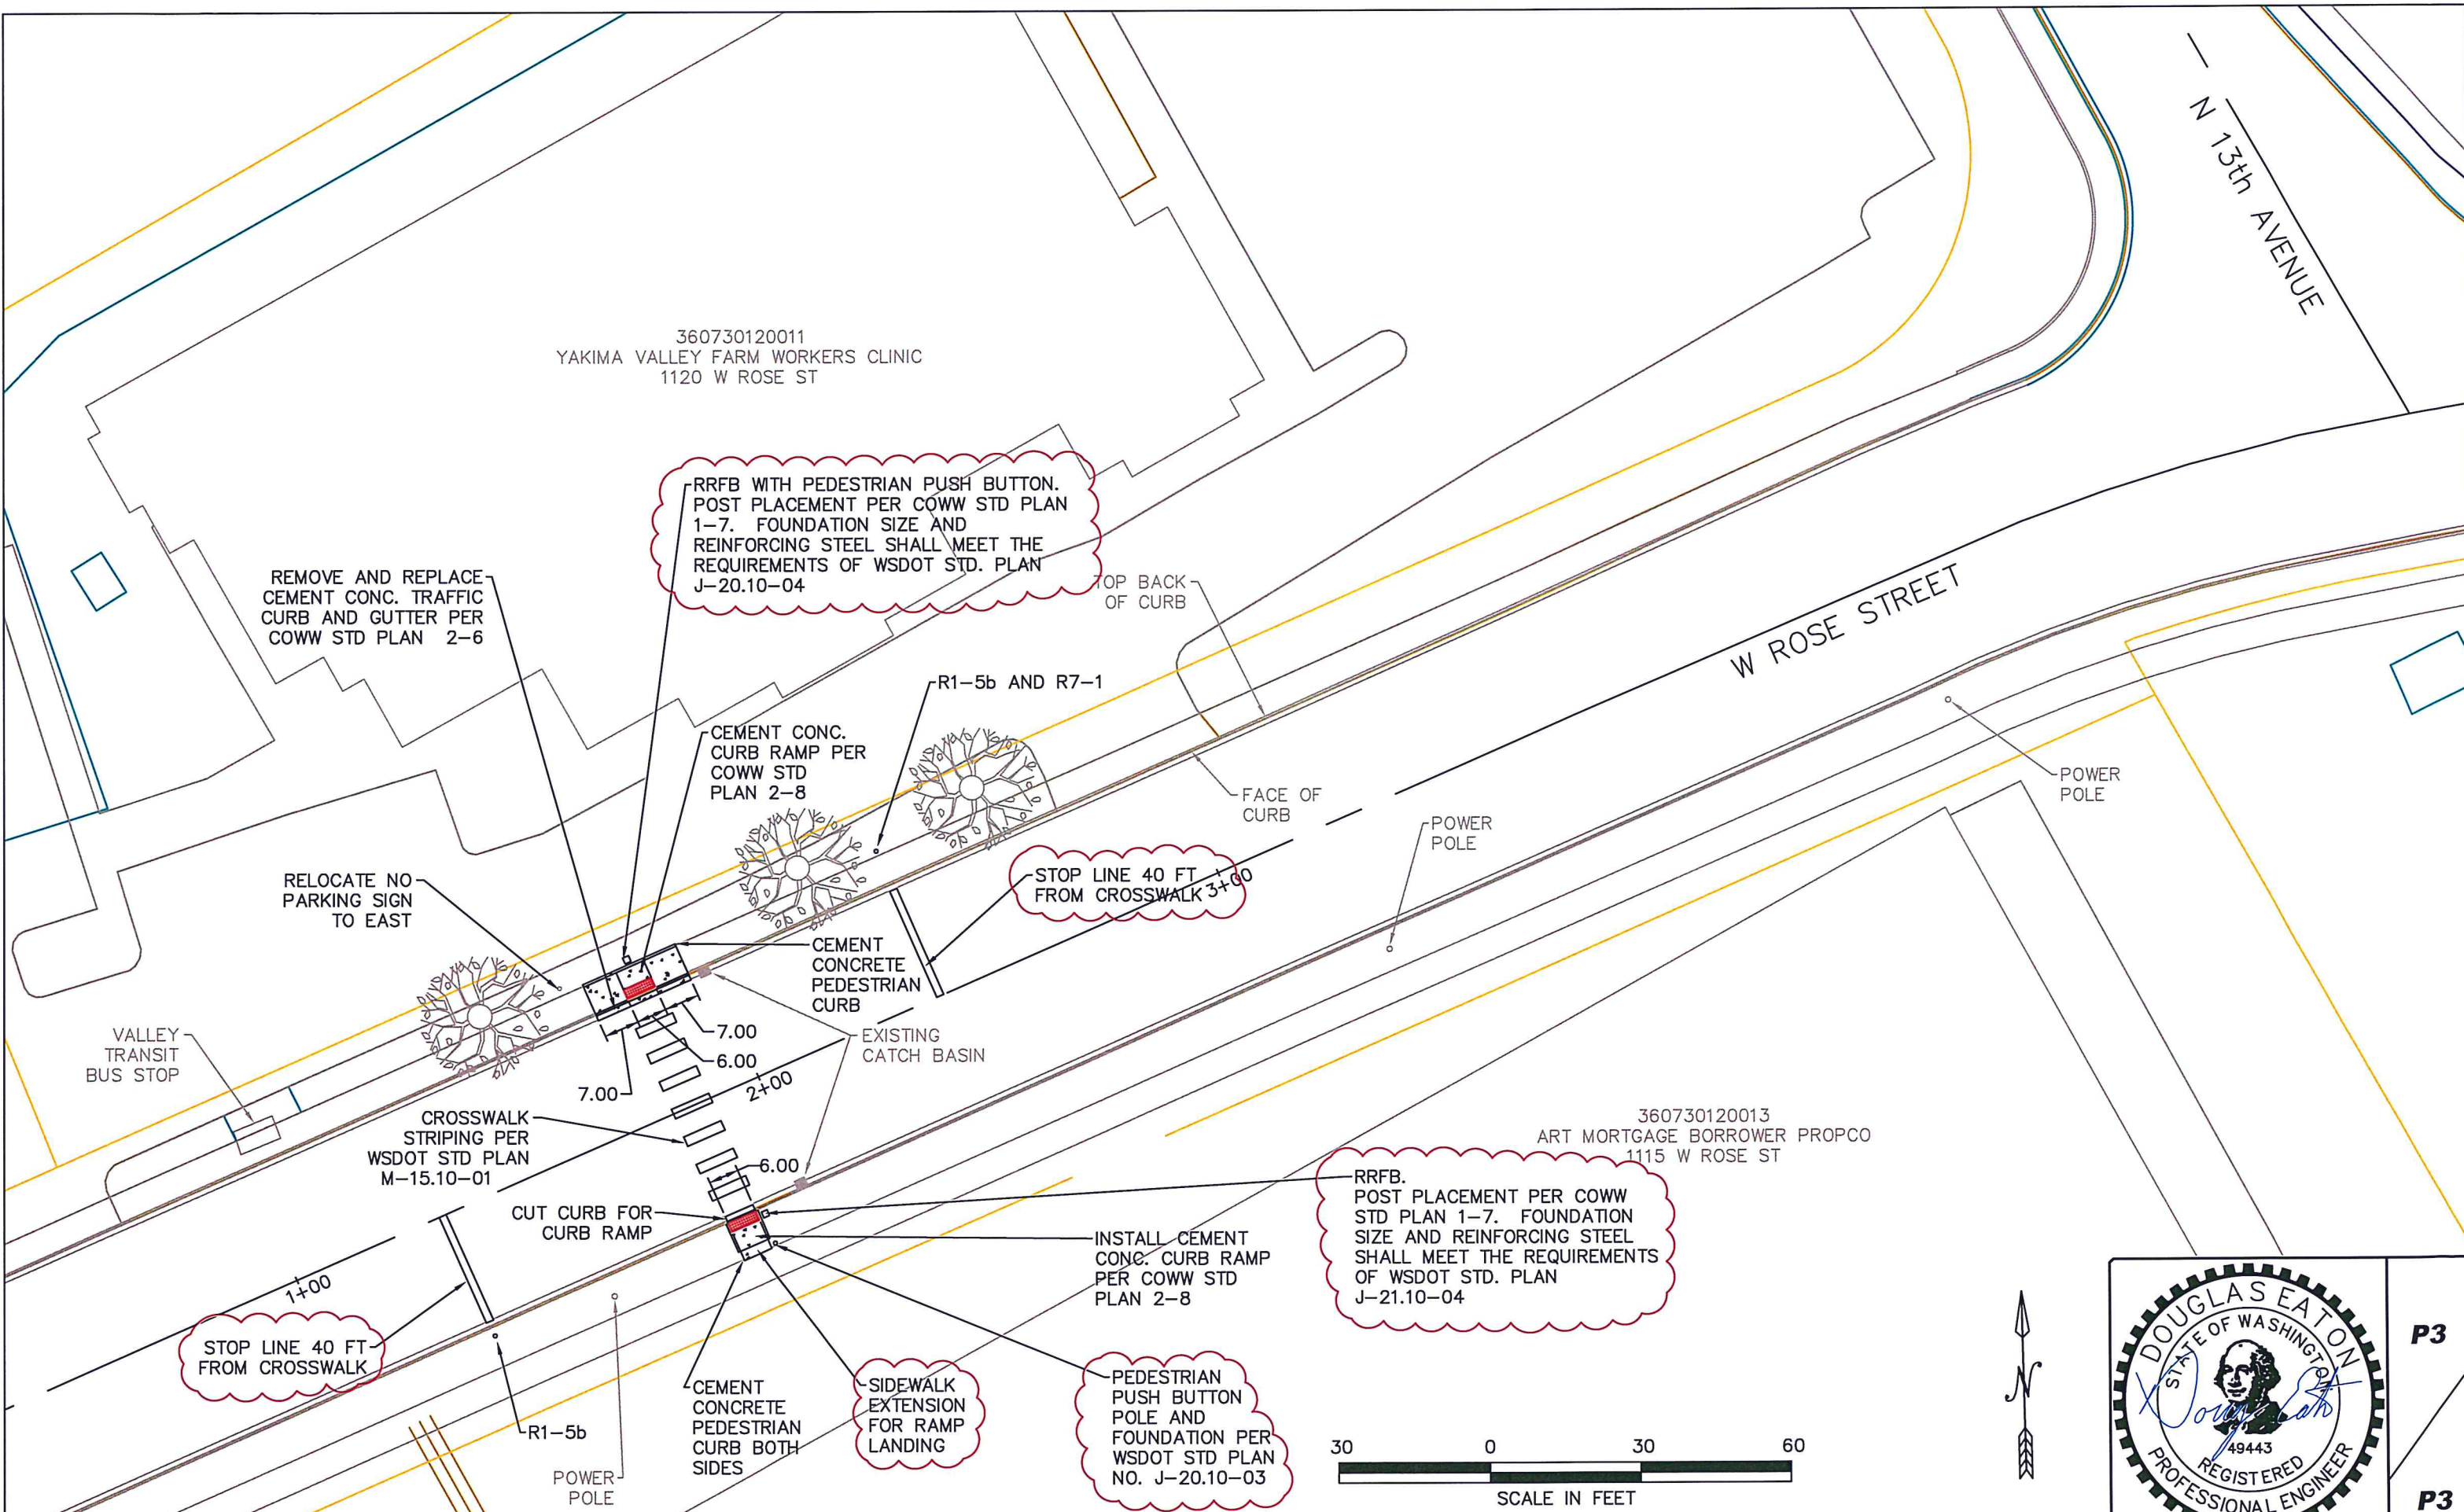


No.	REVISION	BY	Date	Designed By	DWE	Record Dwg	Date
1	ADDENDUM NO. 1	D.E.	3/24/16	Drawn By	JRF	SCALE:	HORIZ. 1" = 30'
				Checked By			VERT. NA
				Approved By			
				Federal Aid No.	TAP-9936(002)	PWE No.	ST14002



Public Works/Engineering
55 E Moore St
Walla Walla, WA 99362

2015 WALLA WALLA PEDESTRIAN IMPROVEMENTS

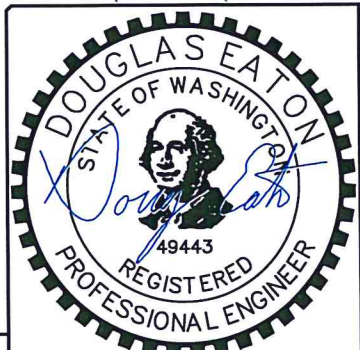

3/24/2016

P3
P3